

Date: Tuesday, 27/03/2007 7:38:41 AM  
 User: Linda Lacelle









## Process Sheet

<b>Customer</b> : CU-DAR001 Dart Helicopters Services	<b>Drawing Name</b> : BRACKET
<b>Job Number</b> : 31301	
<b>Estimate Number</b> : 11181	
<b>P.O. Number</b> : <i>N/A</i>	<b>Part Number</b> : D32941
<b>This Issue</b> : 27/03/2007 <b>S.O. No.</b> : <i>N/A</i>	<b>Drawing Number</b> : D3294 REV A1
<b>Prsht Rev.</b> : NC	<b>Project Number</b> : N/A
<b>First Issue</b> : <i>N/A</i> <b>Type</b> : SMALL /MED FAB	<b>Drawing Revision</b> : A1
<b>Previous Run</b> : 31301	<b>Material</b> : <i>N/A</i>
<b>Written By</b> : _____	<b>Due Date</b> : 03/04/2007 <b>Qty:</b> 10 <b>Um:</b> Each
<b>Checked &amp; Approved By</b> : _____	
<b>Comment</b> : Est A 04.08.24 New issue KJ/JLM Est Rev:B Now On Waterjet 07-03-26 JLM	

## Additional Product

Job Number:



Seq. #:	Machine Or Operation:	Description :
1.0	M2024T3S080	2024-T3 .080 sheet
  <p><b>Comment:</b> Qty.: 2.1072 sf(s)/Unit Total : 21.0725 sf(s)            Material: 2024-T3 (QQ-A-250/4) 0.080" thick            (M2024T3S.080)            Identify for D3294-1            Batch: <i>m102838</i> <i>ml 07 03 28</i> (10)</p>		
2.0	WATER JET	FLOW WATER JET
  <p><b>Comment:</b> FLOW WATER JET            1-Cut as per Dwg D3294            Dwg Rev: <i>A1</i> <i>ml 07 03 29</i> (10)            Prog Rev: <i>A1</i>            2-Deburr if necessary <i>SAD 07/04/01</i></p>		
3.0	QC2	INSPECT PARTS AS THEY COME OFF MACHINE
  <p><b>Comment:</b> INSPECT PARTS AS THEY COME OFF MACHINE <i>ml 07 03 29</i> (10)</p>		
4.0	QC8	SECOND CHECK
  <p><b>Comment:</b> SECOND CHECK <i>07/04/02</i> (8)</p>		

Date: Tuesday, 27/03/2007 7:38:41 AM  
User: Linda Lacelle

## Process Sheet

Customer: CU-DAR001 Dart Helicopters Services

Drawing Name: BRACKET

Job Number: 31301

Part Number: D32941

Job Number:



Seq. #:

Machine Or Operation:

Description :

5.0

SMALL FAB 1

SMALL & MEDIUM FAB RESOURCE 1



Comment: SMALL & MEDIUM FAB RESOURCE 1  
Deburr

SAD 07/04/02 (8)

6.0

BRAKE NC

NC BRAKE



Comment: NC BRAKE  
Form as per Dwg D3294

SB 07/04/11 8

7.0

QC5

INSPECT WORK TO CURRENT STEP



Comment: INSPECT WORK TO CURRENT STEP

07-04-11

8.0

HAND FINISHING1

HAND FINISHING RESOURCE #1



Comment: HAND FINISHING RESOURCE #1  
Chemical Conversion Coat as per QSI 005 4.1

07-04-12 (8)

9.0

POWDER COATING

POWDER COATING



Comment: POWDER COATING  
Powder Coat Black Sandtex (Ref: 4.3.5.7) as per QSI 005 4.3

M1102361  
M-L 07/04/12

10.0

QC3

INSPECT POWDER COAT/CHEMICAL CONVERSION



Comment: INSPECT CHEMICAL CONVERSION COAT

07/4/13 (8)

11.0

PACKAGING 1

PACKAGING RESOURCE #1



Comment: PACKAGING RESOURCE #1  
Identify and Stock  
Location: \_\_\_\_\_

07/4/13 (8)

12.0

QC21

FINAL INSPECTION/W/O RELEASE



Comment: FINAL INSPECTION/W/O RELEASE

07/04/13 (8)

Job Completion



07-04-13

<b>Customer</b>	: CU-DAR001 Dart Helicopters Services	<b>Drawing Name</b>	: BRACKET
<b>Job Number</b>	: 31301		
<b>Estimate Number</b>	: 11181		
<b>P.O. Number</b>	:	<b>Part Number</b>	: D32941
<b>This Issue</b>	: 3/19/2007 <b>S.O. No.</b> :	<b>Drawing Number</b>	: D3294 REV A1
<b>Prsht Rev.</b>	: NC	<b>Project Number</b>	: N/A
<b>First Issue</b>	: / / <b>Type</b> : MACHINED PARTS	<b>Drawing Revision</b>	: A1
<b>Previous Run</b>	:	<b>Material</b>	:
<b>Written By</b>	: _____	<b>Due Date</b>	: 3/30/2007 <b>Qty:</b> 10 <b>Um:</b> Each
<b>Checked &amp; Approved By</b>	: _____ <i>[Signature]</i> 07.03.20		
<b>Comment</b>	: Est A 04.08.24    New issue KJ/JLM		

## Job Number:



Seq. #:	Machine Or Operation:	Description :
1	1000	1000
2	1000	1000
3	1000	1000
1.0 M2024T3S080 2024-T3 .080 sheet



Comment: Qty.: 2.1072 sf(s)/Unit Total : 21.0725 sf(s)  
Material: 2024-T3 (QQ-A-250/4) 0.080" thick  
(M2024T3S.080)  
Identify for D3294-1  
Batch: \_\_\_\_\_

2.0 ~~SHEAR~~ ~~SHEAR~~



Comment: SHEAR  
Cut blank: 1.950" x 0.700" grain along 1.950"  
Note: To be made in multiples of 10

3.0 ~~HAAS~~ ~~WATERLOO~~ HAAS CNC VERTICAL MACHINING #1



**Comment:** HAAS CNC VERTICAL MACHINING #1  
Machine as per Folio FA445 and Dwg D3294  
Stack of 10  
Identify as D3294-1

4.0	QC2	INSPECT PARTS AS THEY COME OFF MACHINE
-----	-----	--



**Comment:** INSPECT PARTS AS THEY COME OFF MACHINE

5.0	QC8	SECOND CHECK
-----	-----	--------------



Comment: SECOND CHECK

W/O:		WORK ORDER CHANGES					
DATE	STEP	PROCEDURE CHANGE	By	Date	Qty	Approval Chief Eng / Prod Mgr	Approval QC Inspector

Part No: \_\_\_\_\_ PAR #: \_\_\_\_\_ Fault Category: \_\_\_\_\_ NCR: Yes No DQA: \_\_\_\_\_ Date: \_\_\_\_\_

QA: N/C Closed: \_\_\_\_\_ Date: \_\_\_\_\_

NCR:		WORK ORDER NON-CONFORMANCE (NCR)						
DATE	STEP	Description of NC Section A	Corrective Action Section B			Verification Section C	Approval Chief Eng	Approval QC Inspector
			Initial Chief Eng	Action Description Chief Eng	Sign & Date			

NOTE: Date & initial all entries

Date: Monday, 3/19/2007 4:38:14 PM  
User: Kim Johnston

## Process Sheet

Customer: CU-DAR001 Dart Helicopters Services

Drawing Name: BRACKET

Job Number: 31301

Part Number: D32941

Job Number:



Seq. #:

Machine Or Operation:

Description :

6.0

SMALL FAB 1

SMALL & MEDIUM FAB RESOURCE 1



Comment: SMALL & MEDIUM FAB RESOURCE 1  
Deburr

7.0

BRAKE NC

NC BRAKE



Comment: NC BRAKE  
Form as per Dwg D3294

8.0

QC5

INSPECT WORK TO CURRENT STEP



Comment: INSPECT WORK TO CURRENT STEP

9.0

HAND FINISHING1

HAND FINISHING RESOURCE #1



Comment: HAND FINISHING RESOURCE #1  
Chemical Conversion Coat as per QSI 005 4.1

10.0

POWDER COATING

POWDER COATING



Comment: POWDER COATING  
Powder Coat Black Sandtex (Ref: 4.3.5.7) as per QSI 005 4.3

11.0

QC3

INSPECT POWDER COAT/CHEMICAL CONVERSION



Comment: INSPECT CHEMICAL CONVERSION COAT

12.0

PACKAGING 1

PACKAGING RESOURCE #1



Comment: PACKAGING RESOURCE #1  
Identify and Stock  
Location: \_\_\_\_\_

13.0

QC21

FINAL INSPECTION/W/O RELEASE



Comment: FINAL INSPECTION/W/O RELEASE

Job Completion



W/O:		WORK ORDER CHANGES					
DATE	STEP	PROCEDURE CHANGE	By	Date	Qty	Approval Chief Eng / Prod Mgr	Approval QC Inspector

Part No: \_\_\_\_\_ PAR #: \_\_\_\_\_ Fault Category: \_\_\_\_\_ NCR: Yes No DQA: \_\_\_\_\_ Date: \_\_\_\_\_

QA: N/C Closed: \_\_\_\_\_ Date: \_\_\_\_\_

NCR:		WORK ORDER NON-CONFORMANCE (NCR)						
DATE	STEP	Description of NC Section A	Corrective Action Section B			Verification Section C	Approval Chief Eng	Approval QC Inspector
			Initial Chief Eng	Action Description Chief Eng	Sign & Date			

**NOTE:** Date & initial all entries






DESIGN	CP	DRAWN BY	CP	DART AEROSPACE LTD HAWKESBURY, ONTARIO, CANADA	
CHECKED	TH	APPROVED	TH	DRAWING NO. D3294	REV. A SHEET 1 OF 2
DATE	04.06.28			TITLE BRACKET	SCALE 1:3
A	04.06.28			NEW ISSUE	
AI	UR	05.06.13			12.97 WAS 13.63, AS MANUFACTURED

RELEASED  
04.07.12

D3294-1 BRACKET

- 1) MACHINE PER DRAWING FILE "D3294-A2.DWG"
- 2) CHECK PER TEMPLATE D3294-1T1
- 3) MATERIAL: 2024-T3 (QQ-A-250/4) SHEET 0.080 THICK (REF. DART SPEC M2024T3S.080)
- 4) FINISH: CHEMICAL CONVERSION COAT PER DART QSI 005 4.1  
POWDER COAT BLACK SANDTEX (4.3.5.7) PER DART QSI 005 4.3
- 5) USE MINIMUM BEND RADIUS OF 0.188"
- 6) TOLERANCES ARE PER DART QSI 018 UNLESS OTHERWISE NOTED

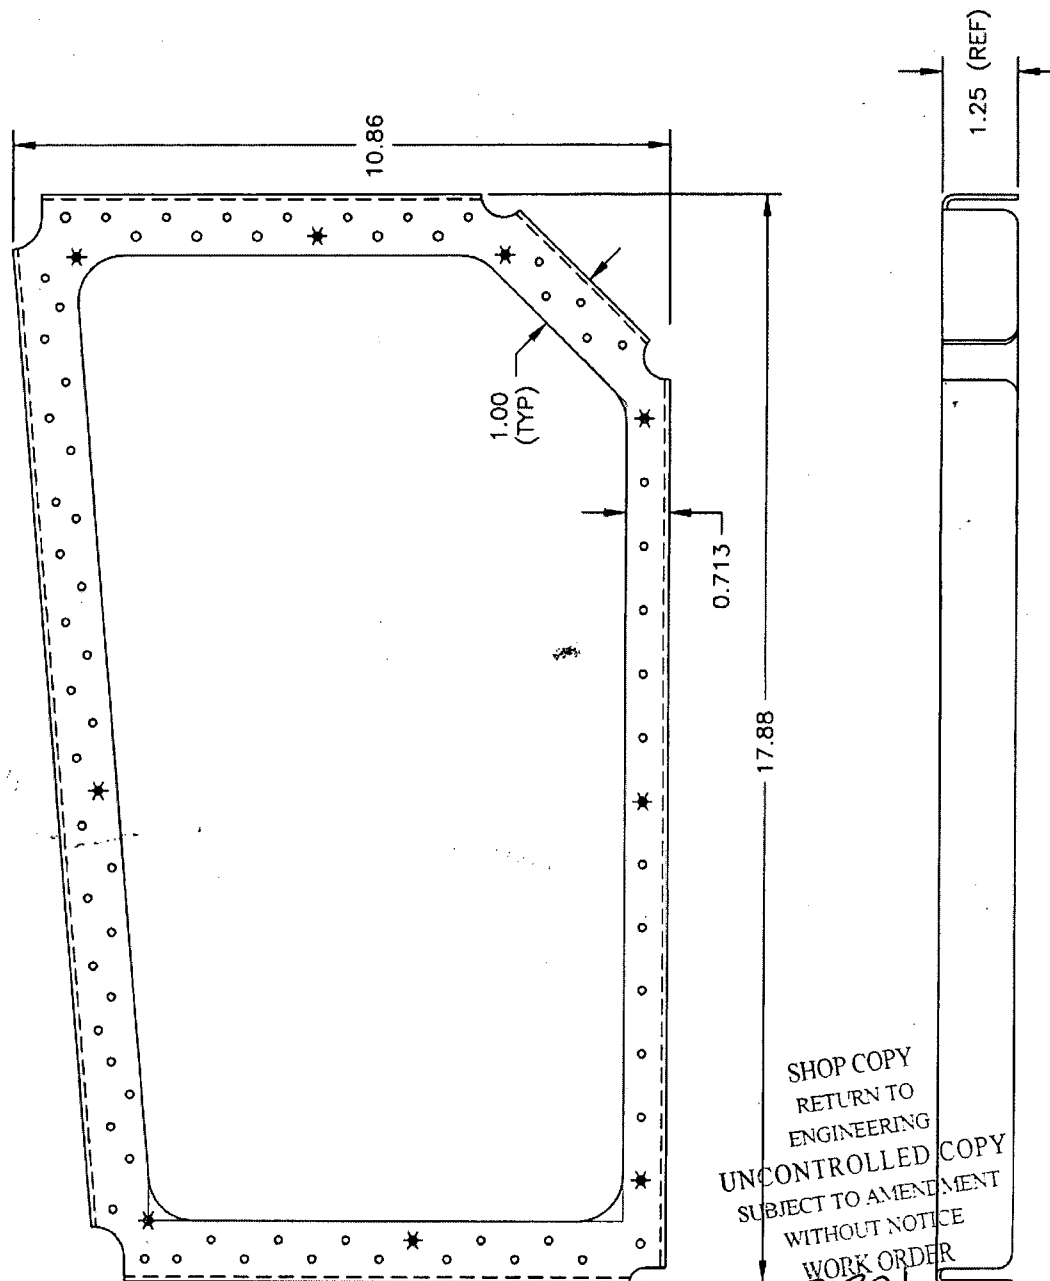

SHOP COPY  
RETURN TO  
ENGINEERING  
UNCONTROLLED COPY  
SUBJECT TO AMENDMENT  
WITHOUT NOTICE  
WORK ORDER  
NO 31301

Copyright © 2004 by DART AEROSPACE LTD

THIS DOCUMENT IS PRIVATE AND CONFIDENTIAL AND IS SUPPLIED ON THE EXPRESS CONDITION THAT IT IS NOT TO BE USED FOR ANY PURPOSE OR COPIED OR COMMUNICATED TO ANY OTHER PERSON WITHOUT WRITTEN PERMISSION FROM DART AEROSPACE LTD.






DESIGN <i>CP</i>	DRAWN BY <i>CP</i>	<b>DART AEROSPACE LTD</b> HAWKESBURY, ONTARIO, CANADA	
CHECKED <i>[Signature]</i>	APPROVED <i>[Signature]</i>	DRAWING NO. <b>D3294</b>	REV. A SHEET 2 OF 2
DATE <b>04.06.28</b>		TITLE <b>BRACKET</b>	SCALE <b>1:3</b>

**D3294-1 FLAT PATTERN**

RELEASED  
04.07.12

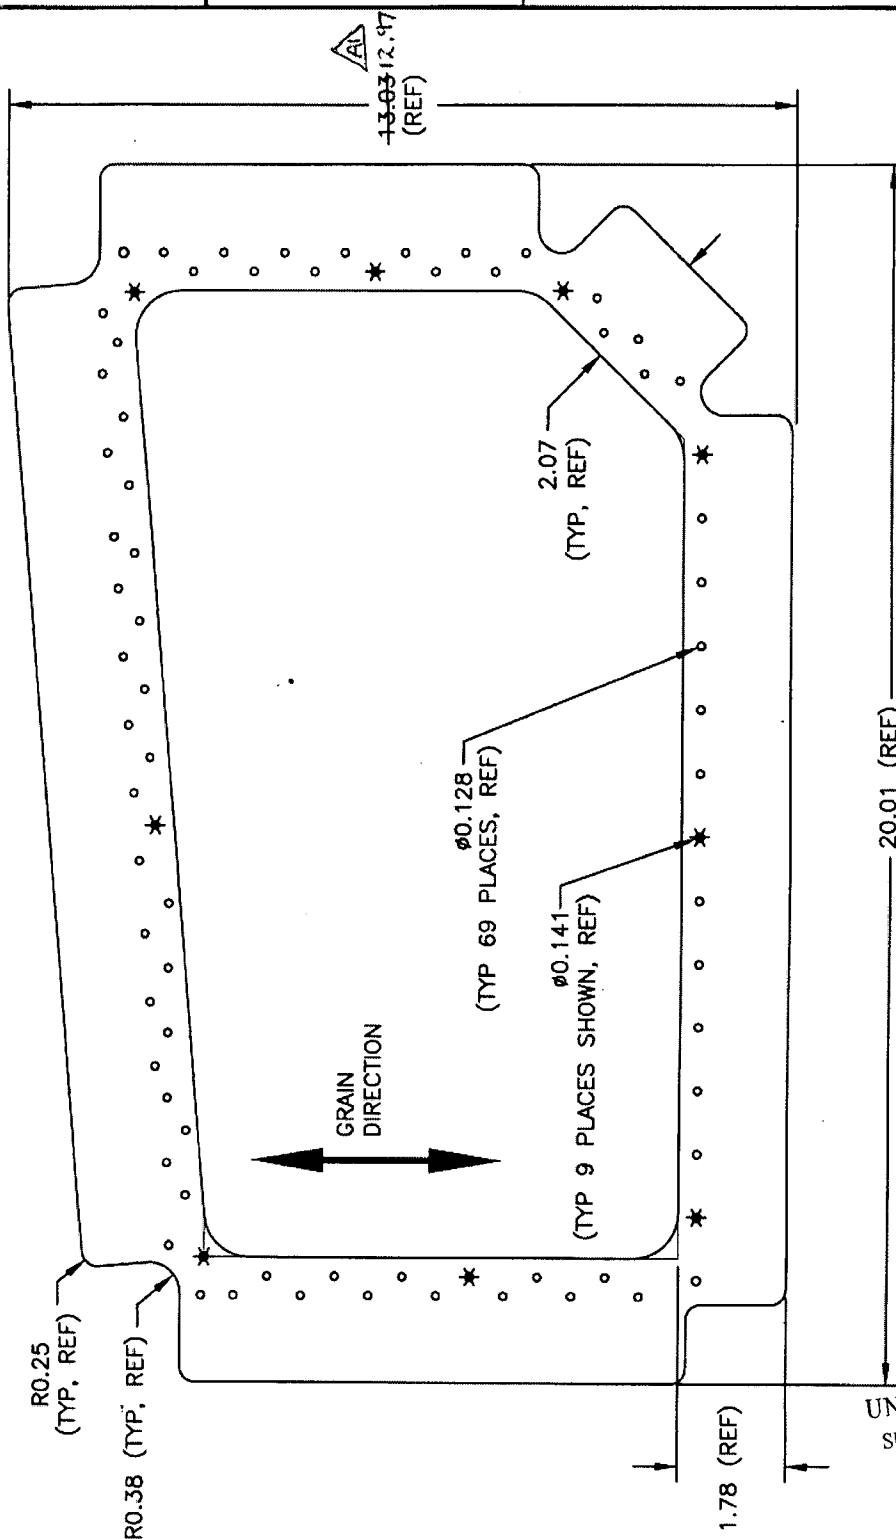

SHOP COPY  
RETURN TO  
ENGINEERING  
UNCONTROLLED COPY  
SUBJECT TO AMENDMENT  
WITHOUT NOTICE  
WORK ORDER  
NO. 31301





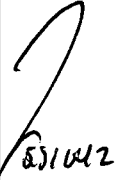



Copyright © 2004 by DART AEROSPACE LTD

THIS DOCUMENT IS PRIVATE AND CONFIDENTIAL AND IS SUPPLIED ON THE EXPRESS CONDITION THAT IT IS NOT TO BE USED FOR ANY PURPOSE OR COPIED OR COMMUNICATED TO ANY OTHER PERSON WITHOUT WRITTEN PERMISSION FROM DART AEROSPACE LTD.

Dart Aerospace Ltd

W/O:		WORK ORDER CHANGES					
DATE	STEP	PROCEDURE CHANGE	By	Date	Qty	Approval Chief Eng / Prod Mgr	Approval QC Inspector
07.04.02	2	One <del>Ø0.128</del> HOLE					

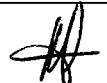Part No: \_\_\_\_\_ PAR #: \_\_\_\_\_ Fault Category: \_\_\_\_\_ NCR: Yes ☒ No ☐ DQA: ☒ ☐ Date: 07/04/02  
 QA: N/C Closed: \_\_\_\_\_ Date: \_\_\_\_\_

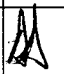NCR:		WORK ORDER NON-CONFORMANCE (NCR)						
DATE	STEP	Description of NC Section A	Corrective Action Section B			Verification Section C	Approval Chief Eng	Approval QC Inspector
			Initial Chief Eng	Action Description Chief Eng	Sign & Date			
07.04.02	2	One <del>Ø0.128</del> HOLE DRILLED <del>Ø0.154</del> ON QTY(5) PARTS.		PARTS ACCEPTABLE. PROBLEM WAS WITH DUG & FLAT PATTERN.	N/A	 07/04/02	 07.04.02	 07/04/02
07/04/02	2	2 part scrap the Ø.128" hole are over size at Ø.135" out of tol	 07/04/02	-destroy	SB 07/04/02	 07/04/02	 07/04/02	 07/04/02

NOTE: Date & initial all entries